


See Page: 017-i

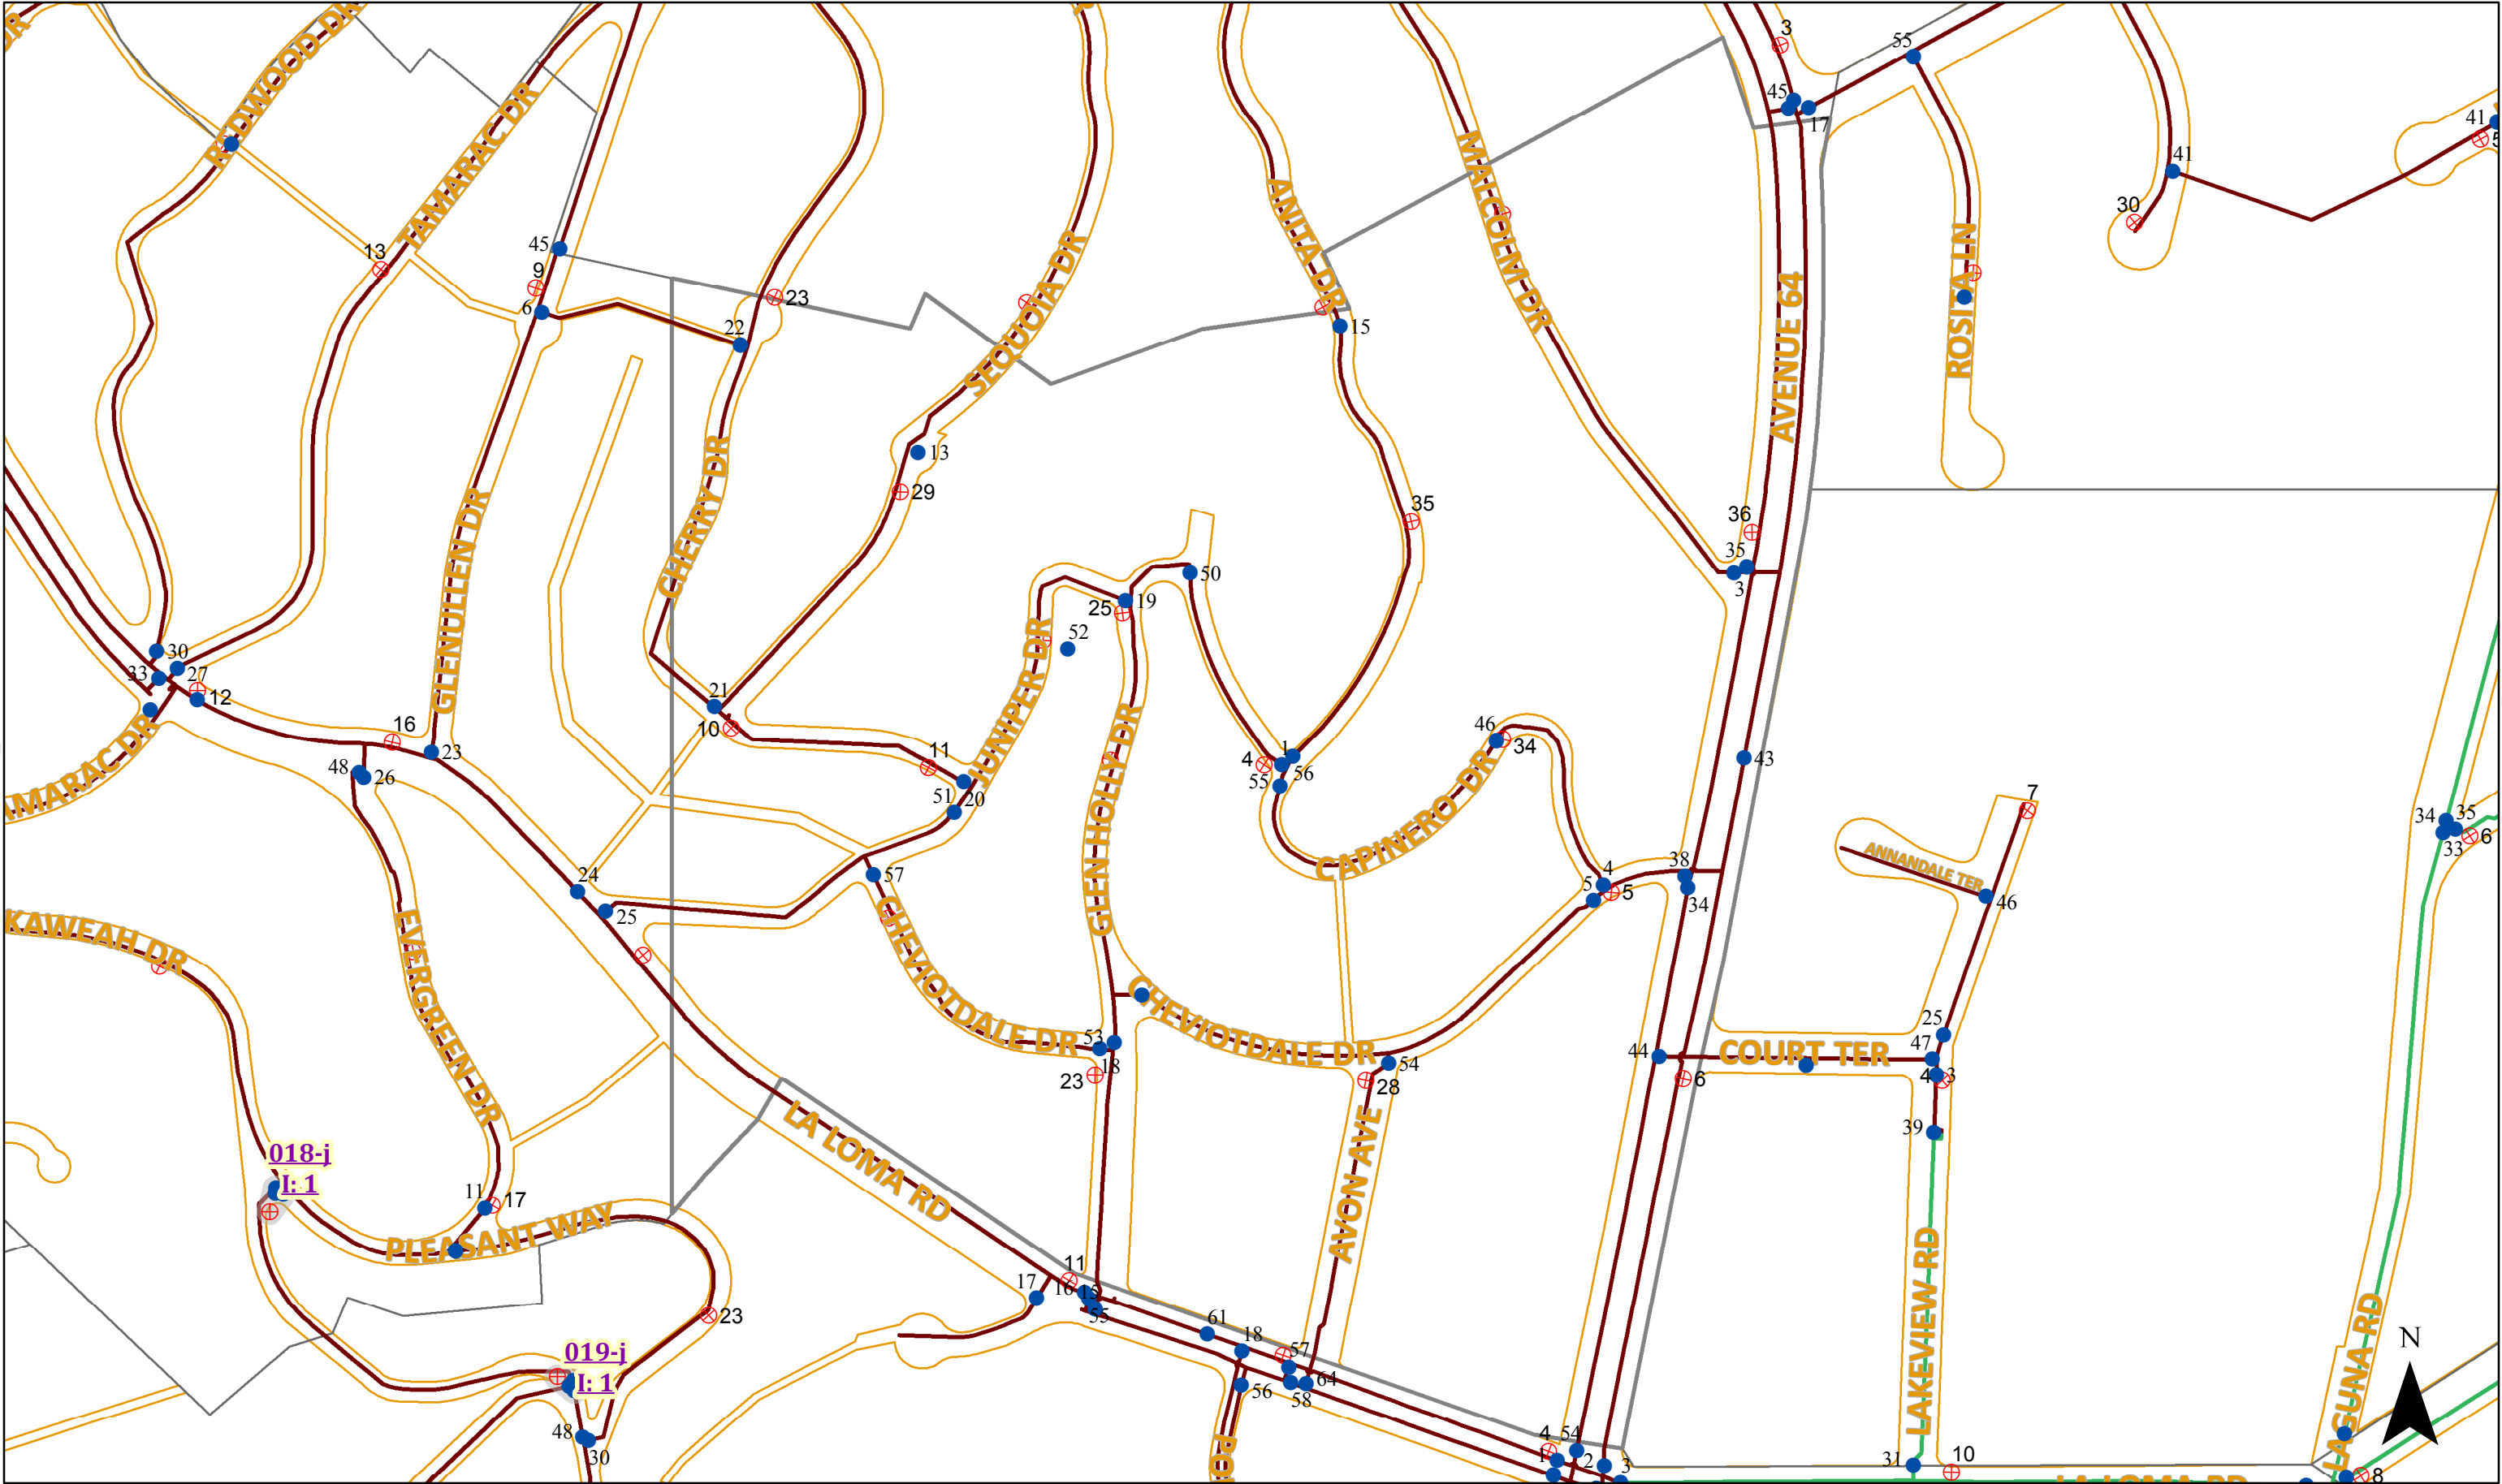

See Page: 118-i


See Page: 018-i

See Page: 019-i


See Page: 0017-i

See Page: 018-i

See Page:

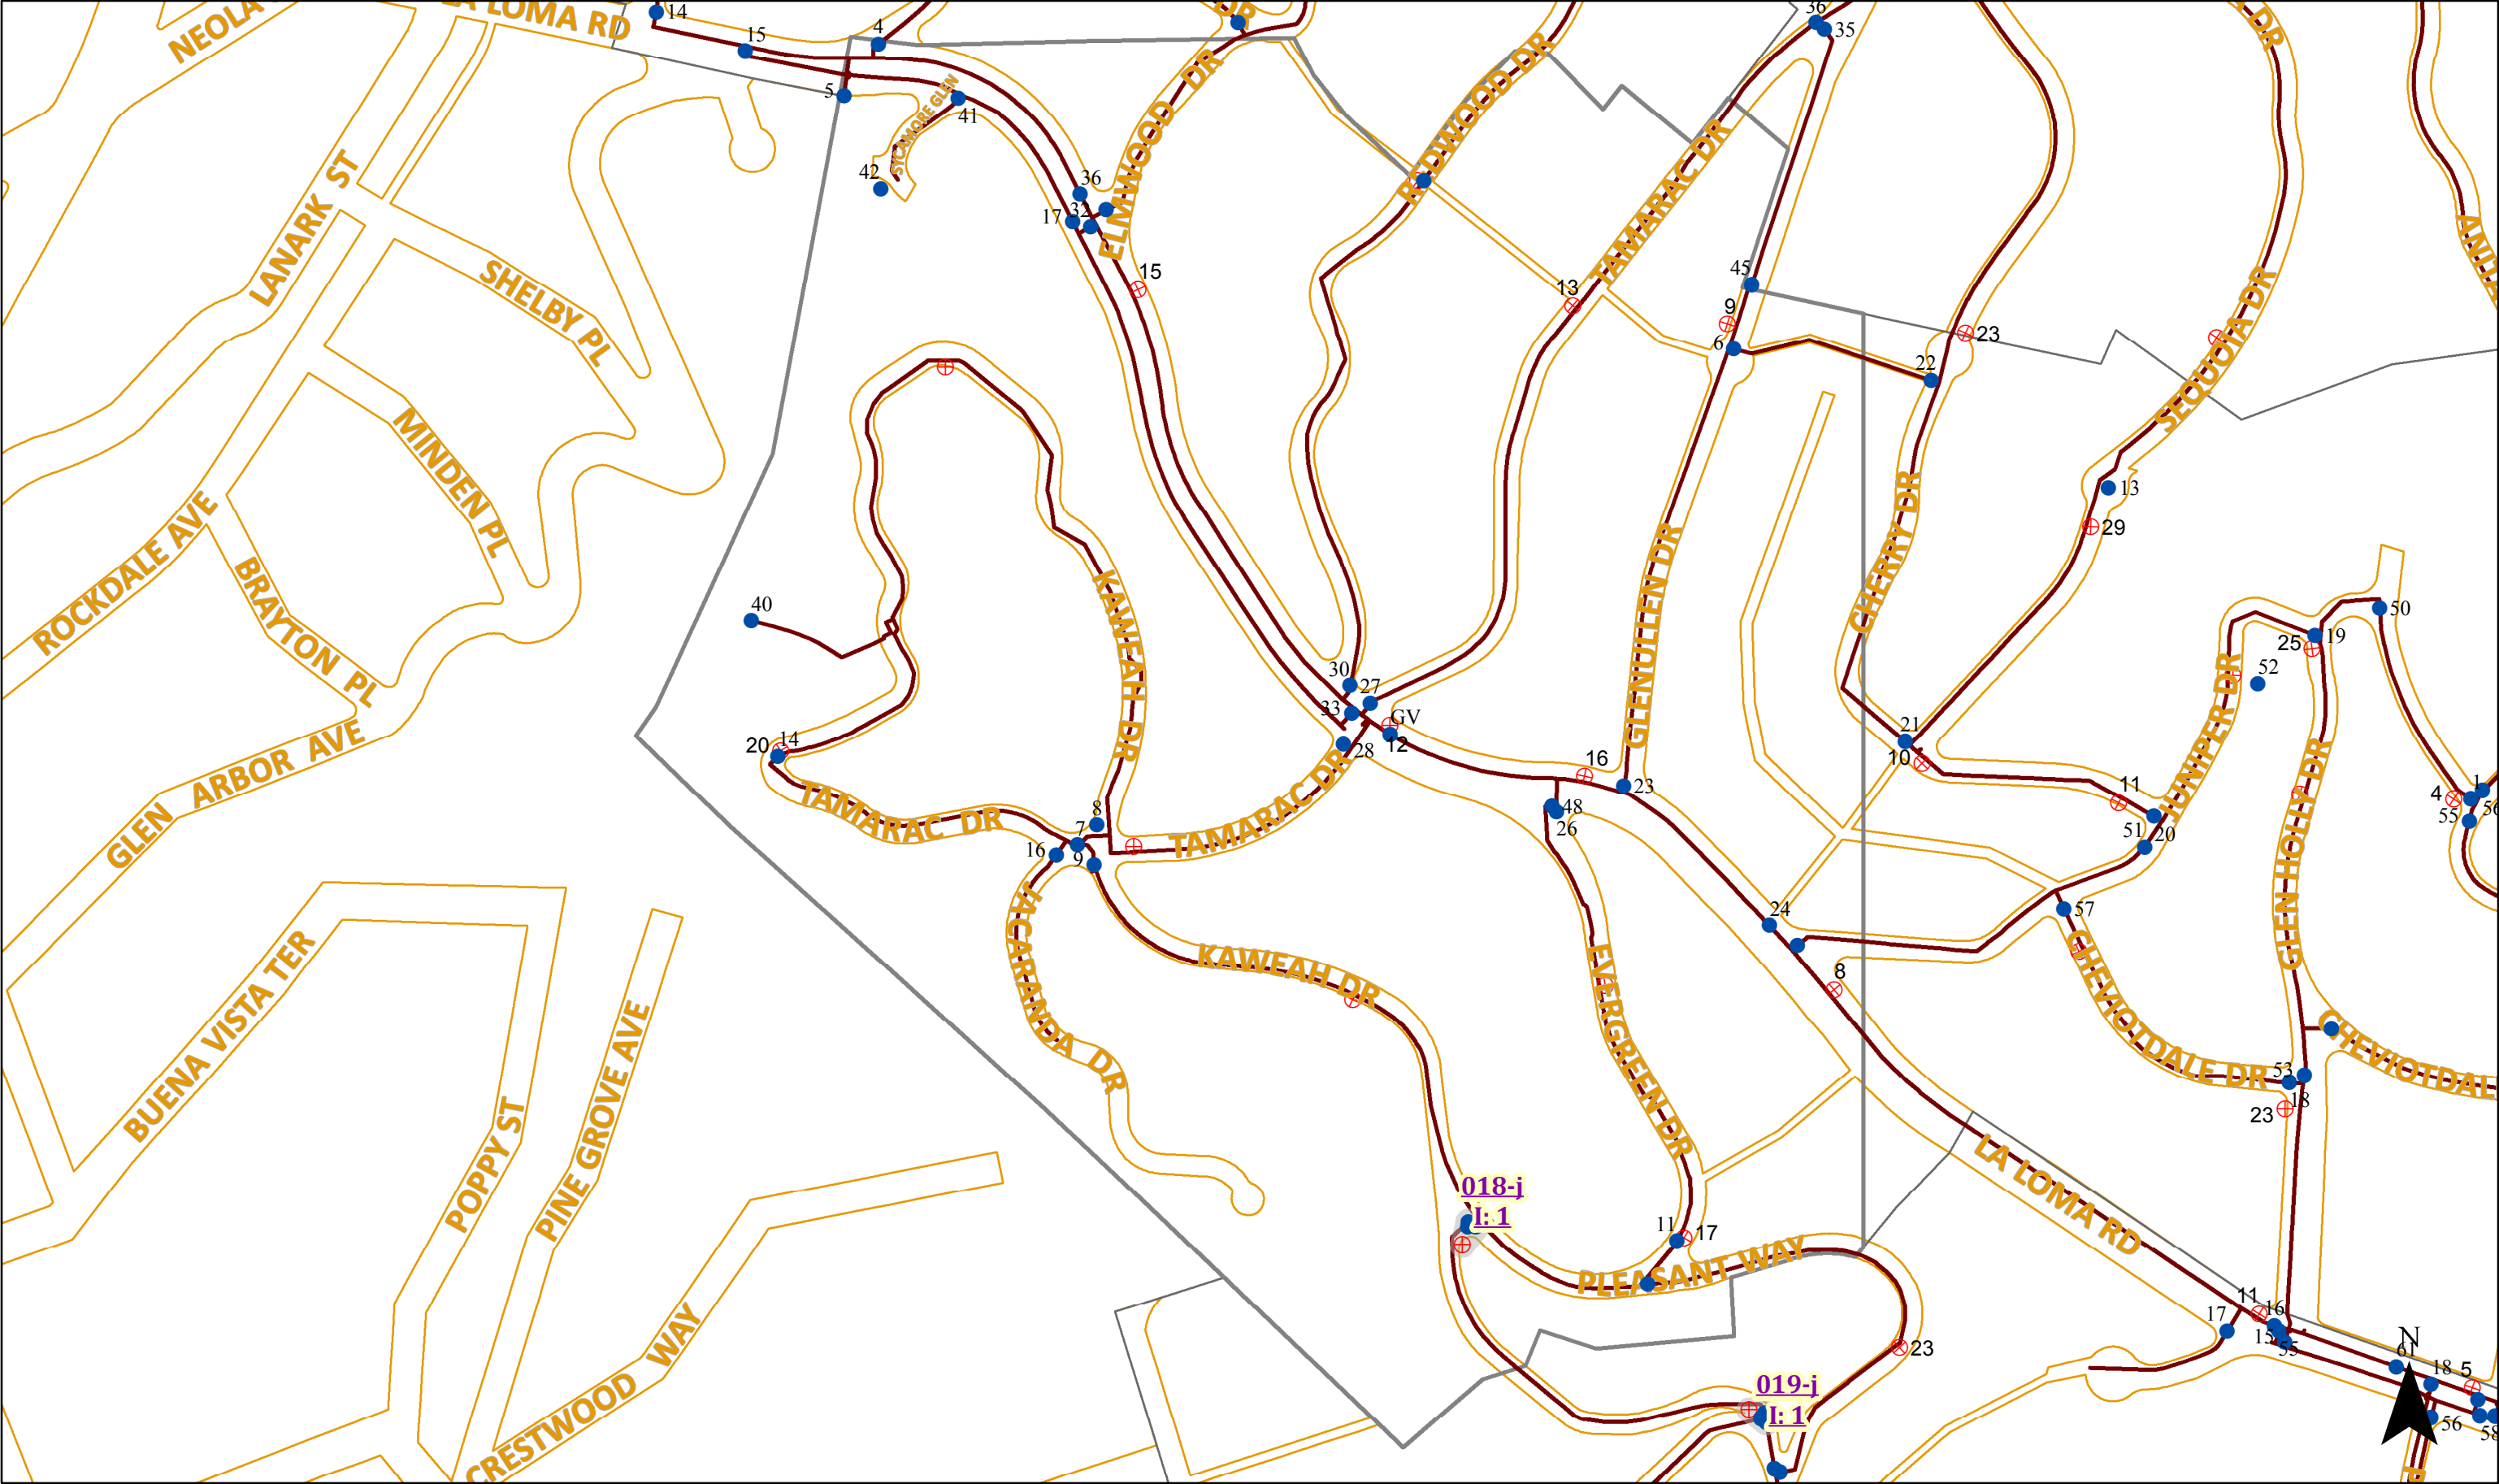

See Page: 019-j

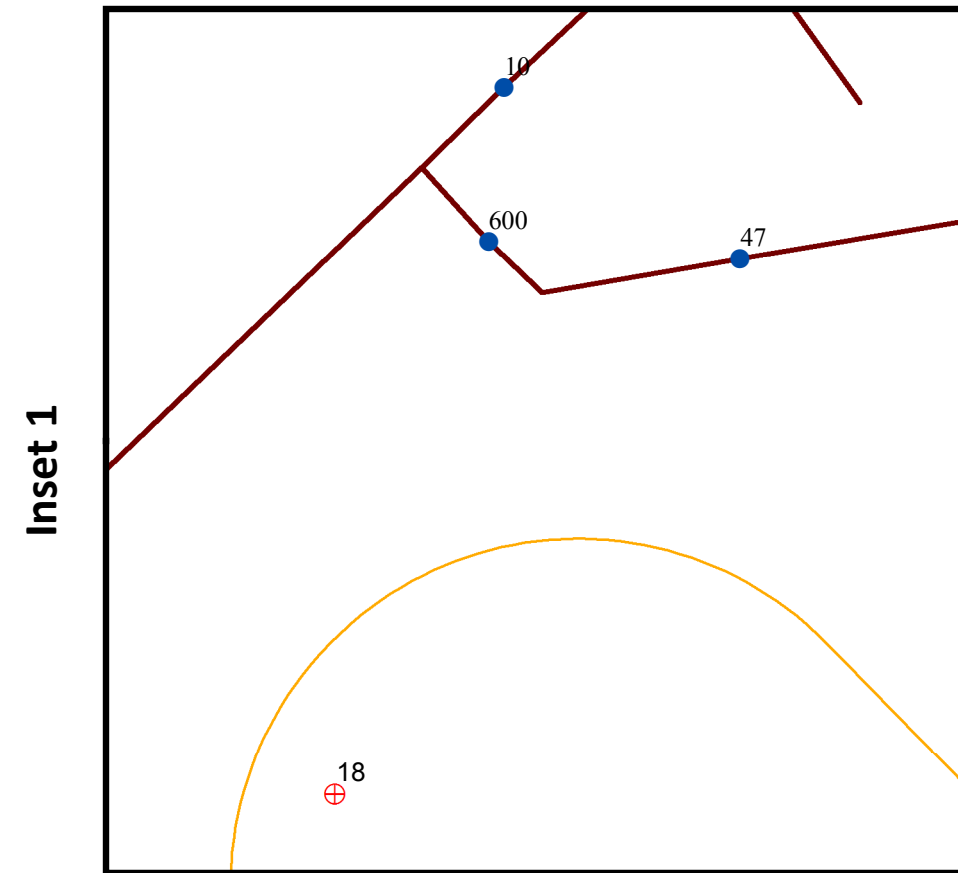

GATE BOOK - Gate Valve Table

NO.	SIZE	KIND	DATE INSTLD	TURNS	FT OF PL CURB A	STREET A	FT OF PL CURB B	STREET B	PWP COMMENTS
1	6.0	CLOW	07/01/1999	19.5 L	0.0 UNK	UNK -	11.0 WE	UNK -	TO STREET ON SHEET-CAPERERO GOING NW, FROM STREET ON SH...
2	8.0	CLOW	01/01/1993	26.25 L	7.0 EE	GLEN HOLLY DR	19.0 NS	CHEVIOTDALE DR	W.O. 6583 TO 4" CI, TO-MEASURED DUE SOUTH, FEEDER FROM
3	6.0	CRANE	12/01/1936	13.0 L	0.0 W	AVENUE 64 AVE	8.0 EE	MALCOLM DR	480.5
4	6.0	UNK	11/28/2000	19.5 L	9.0 SN	CHEVIOTDALE DR	13.0 WW	CAPINERO DR	FROM - SOMEWHERE IN STREET NEAR FIREPLUG #5, TO-SORRY N...
5	6.0	CHAP	01/01/1926	26.5 L	11.75 SS	LA LOMA RD	7.0 EW	UNK -	CLOSED STUB, AT CITY LIMITS
5	4.0	CHAP	01/01/1924	14.5 L	21.5 S	CAPINERO DR	4.0 NS	CHEVIOTDALE DR	VALVE SIZE MISMATCH
6	6.0	UNK	10/01/1997	18.5 L	8.0 EW	GLENULLEN DR	11.0 NN	UNK -	BY D. ANDERSON, TO CITY WALKWAYSTAIRS
7	6.0	KEN	11/01/1927	13.0 L	48.0 W	KAWEAH DR	28.0 N	TAMARAC DR	28' NE POLE 11820M, 56
8	6.0	KEN	04/14/2006	25.5 L	29.5 -	KAWEAH DR	41.5 N	KAWEAH DR	29.5' TO GATE 7, 56, HOUSE 538 S WALL, 41.5' N OF MH
9	6.0	KEN	04/14/2006	25.5 L	15.0 N	KAWEAH DR	- -	- -	15' N of the W F/H Kaweah Dr; 66' N of the E Pole #1182...
10	6.0	KEN	11/01/1927	13.0 L	23.0 N	PLEASANT WAY	45.5 E	KAWEAH DR	23' N ON WALL, 56
11	6.0	AWWA	12/01/1997	19.0 L	12.5 EW	EVERGREEN DR	46.5 UNK	PLEASANT WAY	NO SLIP
12	6.0	UNK	12/01/1997	19.0 L	25.0 W	EVERGREEN DR	20.5 N	PLEASANT WAY	FIRE PLUG 17 ON NE CORNER
13	6.0	RENS	01/01/2999	0.0 -	0.0 UNK	CHERRY DR	0.0 UNK	SEQUOIA DR	NO AS BUILT;VALVE SIZE MISMATCH
14	6.0	MUELL	11/01/1981	20.25 L	25.5 UNK	TAMARAC DR	35.0 UNK	TAMARAC DR	HOUSE 596, HOUSE 600
15	6.0	UNK	08/01/1999	19.5 L	8.0 EW	ANITA DR	610.0 NN	CAPINERO DR	BY VIRGIL JACKSON
16	6.0	RENS	03/01/1956	22.0 L	30.0 N	JACARANDA DR	30.0 W	JACARANDA DR	30'+- ON WALL
17	8.0	RENS	03/01/1964	28.0 L	45.0 EW	LA LOMA DR	16.0 NS	LA LOMA RD	HOUSE 1812 OPPOSITE ELMWOOD DR
18	8.0	CLOW	01/06/1993	26.25 L	0.0 W	GLEN HOLLY DR	4.0 NS	CHEVIOTDALE DR	W.O. 6583, REDUCER 8 TO 4
19	6.0	CLOW	11/01/1992	19.75 L	13.0 WE	GLEN HOLLY DR	10.0 NS	JUNIPER DR	W.O. 6580, FEEDER FROM 8"
20	6.0	CLOW	12/22/1992	19.75 L	0.0 W	JUNIPER DR	20.0 SN	CHERRY DR	W.O. 6580, 20' W OF MH ON WEST CURB LINE, PRODUCED
21	4.0	CHAP	04/01/1926	14.25 L	0.0 W	SEQUOIA DR	11.0 S	CHERRY DR	IN LINE WITH MANHOLE
22	0.0	UNK	01/01/2999	0.0 -	0.0 UNK	UNK -	0.0 UNK	UNK -	VALVE SIZE MISMATCH
23	6.0	UNK	10/01/1997	18.5 L	7.0 EW	GLENULLEN DR	12.0 SN	LA LOMA RD	PROD.
24	8.0	CHAP	01/01/1926	27.0 L	0.0 E	UNK -	20.0 SN	LA LOMA RD	FROM ALLEY
25	6.0	CHAP	01/01/1926	26.5 L	50.0 NS	LA LOMA RD	43.0 E	JUNIPER DR	43' E ON STEPS
26	6.0	UNK	01/01/2999	- L	- -	- -	- -	- -	-
27	8.0	CHAP	01/01/1926	26.5 L	4.0 EW	TAMARAC DR	0.0 N	LA LOMA RD	-
28	6.0	CHAP	01/01/1926	26.5 L	43.0 S	TAMARAC DR	38.5 S	LA LOMA RD	13' E OF MH 4.5' S OF CONCRETE, LIGHT PAST SE LALOMA & ...
30	6.0	CHAP	01/01/1926	26.5 L	5.75 WW	TAMARAC DR	32.0 NS	LA LOMA RD	-
31	6.0	UNK	01/27/2006	18.25 L	11.0 WE	REDWOOD DR	7.0 S	UNK -	7' S of FH018-14
32	6.0	RENS	04/01/1964	21.5 L	28.75 W	LA LOMA RD	24.33 SN	LA LOMA RD	"X" ON W CR ELMWOOD DR.
33	6.0	RENS	05/30/2006	28.75 L	23.0 NS	REDWOOD DR	6.0 W	TAMARAC DR	"X" ON W CR REDWOOD DR, "X" ON S CURB LA LOMA RD
34	12.0	RENS	03/01/1965	40.0 L	5.0 SS	CHEVIOTDALE DR	23.0 EW	AVENUE 64 AVE	PROD TO WEST
35	6.0	RENS	04/01/1965	21.5 L	20.0 NN	MALCOLM DR	17.0 EW	AVENUE 64 AVE	OR
36	6.0	CHAP	01/11/2007	20.0 L	19.0 S	ELMWOOD DR	28.5 NS	LA LOMA RD	-
37	6.0	CHAP	01/01/1926	26.0 L	12.5 EW	ELMWOOD DR	12.5 NN	LA LOMA RD	-
38	6.0	RENS	03/01/1965	21.5 L	8.5 NS	CHEVIOTDALE DR	20.0 EW	AVENUE 64 AVE	BYPASS
40	6.0	MUELL	06/01/1989	20.0 L	204.0 WW	TAMARAC DR	20.0 SN	KAWEAH DR	COMBO SYSTEM AND SHUTOFF VALVE FOR FH 018-2
41	4.0	CLOW	11/01/1991	15.0 L	8.0 NS	LA LOMA RD	50.0 WE	UNK -	-

GATE BOOK - Gate Valve Table

NO.	SIZE	KIND	DATE INSTLD	TURNS	FT OF PL CURB A	STREET A	FT OF PL CURB B	STREET B	PWP COMMENTS
42	1.0	UNK	12/01/1991	0.0 -	0.0 UNK	SYCAMORE GLEN WAY	134.0 SS	LA LOMA RD	BURIED TAP, A-1 MAIN WO 6550, CURBSTOP, CORP 132 SS, SY...
43	6.0	CLOW	10/01/1992	20.0 L	350.0 NN	COURT TER	23.0 WE	AVENUE 64 AVE	WO 6578, SEE 118
44	8.0	CLOW	08/01/1992	27.0 L	34.0 SN	COURT TER	24.0 EW	AVENUE 64 AVE	FOR COUNTER, FEEDS COURT TERRACE, WO 6578
45	6.0	UNK	10/01/1997	0.0 -	0.0 UNK	UNK -	0.0 EW	GLENULLEN DR	WO 6581
46	6.0	UNK	07/01/1999	19.5 L	274.0 NN	CHEVIOTDALE DR	11.0 EW	CAPINERO DR	3' FROM FH #34, FIRE PLU 018-34, BY V. JACKSON
47	6.0	CLOW	02/01/1998	19.5 L	12.5 N	PLEASANT WAY	23.0 EE	KAWEAH DR	TAP-MECH ENDS-RW, PRODUCED
48	6.0	CLOW	02/01/1998	19.5 L	49.0 E	EVERGREEN DR	58.0 SN	LA LOMA RD	TAP-MECH ENDS-RW, VALVE 26 BURIED
50	8.0	CLOW	01/06/1993	26.25 L	15.0 N	CAPINERO DR	15.0 WE	CAPINERO DR	ENDS WO 6583, CAPINERO DR AT HOUSE 412, JOINS 8/4 REDUC...
51	6.0	CLOW	12/22/1992	19.75 L	9.0 N	JUNIPER DR	24.0 SS	CHERRY DR	MAIN EXTENDS TO WO 6580 JOINS 6' CI
52	1.0	UNK	12/01/1992	0.25 L	93.0 SS	JUNIPER DR	1.0 S	JUNIPER DR	SHUTOFF FOR AUTO AIR RELEASE, CURBSTOP
53	8.0	CLOW	01/06/1993	26.25 L	0.0 N	CHEVIOTDALE DR	4.0 EW	GLEN HOLLY DR	WO 6583
54	8.0	KEN	09/01/1994	25.5 L	6.0 NS	CHEVIOTDALE DR	39.0 EW	AVON AVE	WO 6579, TO 8/4 REDUCER, MARTINEZ BY TOLLIVER
55	6.0	CLOW	07/01/1999	19.5 L	0.0 S	UNK -	7.0 WE	UNK -	MECH ENDS-RW, TO - CAPERERO GOING NE, FROM - CAPERERO G...
56	6.0	CLOW	07/01/1999	19.75 L	8.0 EW	ANITA DR	6.0 NN	CAPINERO DR	MECH ENDS, RW, BY V. JACKSON
57	6.0	UNK	12/09/2000	19.5 L	19.0 NS	CHEVIOTDALE RD	5.0 EE	JUNIPER DR	BY V. JACKSON
600	6.0	UNK	01/01/2999	--	--	--	--	--	-

GATE BOOK - Hydrant Valve Table

NO.	SIZE	KIND	DATE INSTLD	TURNS	FT OF PL CURB A	STREET A	FT OF PL CURB B	STREET B	PWP COMMENTS
1	6.0	UNK	01/01/1999	0.0 -	0.0 UNK	--	0.0 UNK	--	-
3	6.0	UNK	12/09/2000	19.5 L	0.0 UNK	--	0.0 UNK	--	-
4	6.0	UNK	01/01/1999	0.0 -	0.0 UNK	--	0.0 UNK	--	-
5	6.0	UNK	01/01/1999	0.0 -	0.0 UNK	--	0.0 UNK	--	-
6	6.0	UNK	01/01/1999	0.0 -	0.0 UNK	--	0.0 UNK	--	-
7	6.0	UNK	01/01/1999	0.0 -	0.0 UNK	--	0.0 UNK	--	-
8	6.0	UNK	01/01/1999	0.0 -	0.0 UNK	--	0.0 UNK	--	-
9	6.0	UNK	01/01/1999	0.0 -	0.0 UNK	--	0.0 UNK	--	-
10	6.0	UNK	01/01/1999	0.0 -	0.0 UNK	--	0.0 UNK	--	-
11	6.0	UNK	01/01/1999	0.0 -	0.0 UNK	--	0.0 UNK	--	-
12	6.0	-	09/09/2006	0.0 -	--	TAMARAC DR	--	LA LOMA RD	-
13	6.0	UNK	01/01/1999	0.0 -	0.0 UNK	--	0.0 UNK	--	-
14	6.0	UNK	01/01/1999	0.0 -	0.0 UNK	--	0.0 UNK	--	-
15	6.0	UNK	01/01/1999	0.0 -	0.0 UNK	--	0.0 UNK	--	-
16	6.0	UNK	01/01/1999	0.0 -	0.0 UNK	--	0.0 UNK	--	-
17	6.0	UNK	01/01/1999	0.0 -	0.0 UNK	--	0.0 UNK	--	-
18	6.0	UNK	01/01/1999	0.0 -	0.0 UNK	--	0.0 UNK	--	-
20	6.0	UNK	01/01/1987	21.0 L	0.0 UNK	--	0.0 UNK	--	-
22	6.0	UNK	01/01/1999	0.0 -	0.0 UNK	--	0.0 UNK	--	-
23	6.0	UNK	01/01/1999	0.0 -	0.0 UNK	--	0.0 UNK	--	-
24	6.0	UNK	01/01/1999	0.0 -	0.0 UNK	--	0.0 UNK	--	-
25	6.0	UNK	01/01/1999	0.0 -	0.0 UNK	--	0.0 UNK	--	-
26	6.0	UNK	01/01/1999	0.0 -	0.0 UNK	--	0.0 UNK	--	-
27	6.0	UNK	01/01/1999	0.0 -	0.0 UNK	--	0.0 UNK	--	-
28	6.0	UNK	01/01/1999	0.0 -	0.0 UNK	--	0.0 UNK	--	-
29	6.0	UNK	01/06/2001	19.5 L	0.0 UNK	--	0.0 UNK	--	-
34	6.0	UNK	07/14/1999	19.5 L	271.0 NN	CHEVIOTDALE DR	8.0 EW	CAPINERO DR	-
35	6.0	CLOW	07/26/1999	19.5 L	351.0 NN	CAPINERO DR	8.0 EW	ANITA DR	-
36	6.0	UNK	01/01/1993	0.0 -	57.0 NN	MALCOLM DR	7.0 EW	AVENUE 64 -	-